

BRISTOL WATER DISTRICT
WSID #5002
APPLICATION FOR NEW CONNECTION

Date: OCTOBER 4, 2023

Name: EDWARD F. GERMON

Address: 73 PINE ST, BRISTOL, VT 05443

Telephone: 802 453 3338

Property Owner: EDWARD F. AND ANNE W. GERMON

Parcel Number: LOT # 2

Location: 73 PINE ST. BRISTOL, VT 05443

Type of Connection: SINGLE FAMILY RESIDENTIAL
(single family residential, multi-residential, agricultural, commercial, other)

Commentary: Install new 3/4" copper service from new 3/4" curb on Pine Street that was installed as part of the Pine Street waterline project. This new 3/4" customer service will connect to the existing service outside the house on the south east corner of the building, intercepting the current service to the house and abandoning and capping the 1" service coming to the back of the house from Liberty Street. New line will be burried at 5.5 - 6' deep and bedded in sand above and below as required in the ordinance. Requesting waiver of connection fee as connection already exists, just moving the corp and curb location.

Signature: Edward F. Germon

Date: OCTOBER 4, 2023

Departmental Use Only


Approved: _____

Denied: _____

Remarks: _____

Reviewed by: _____

Date: _____

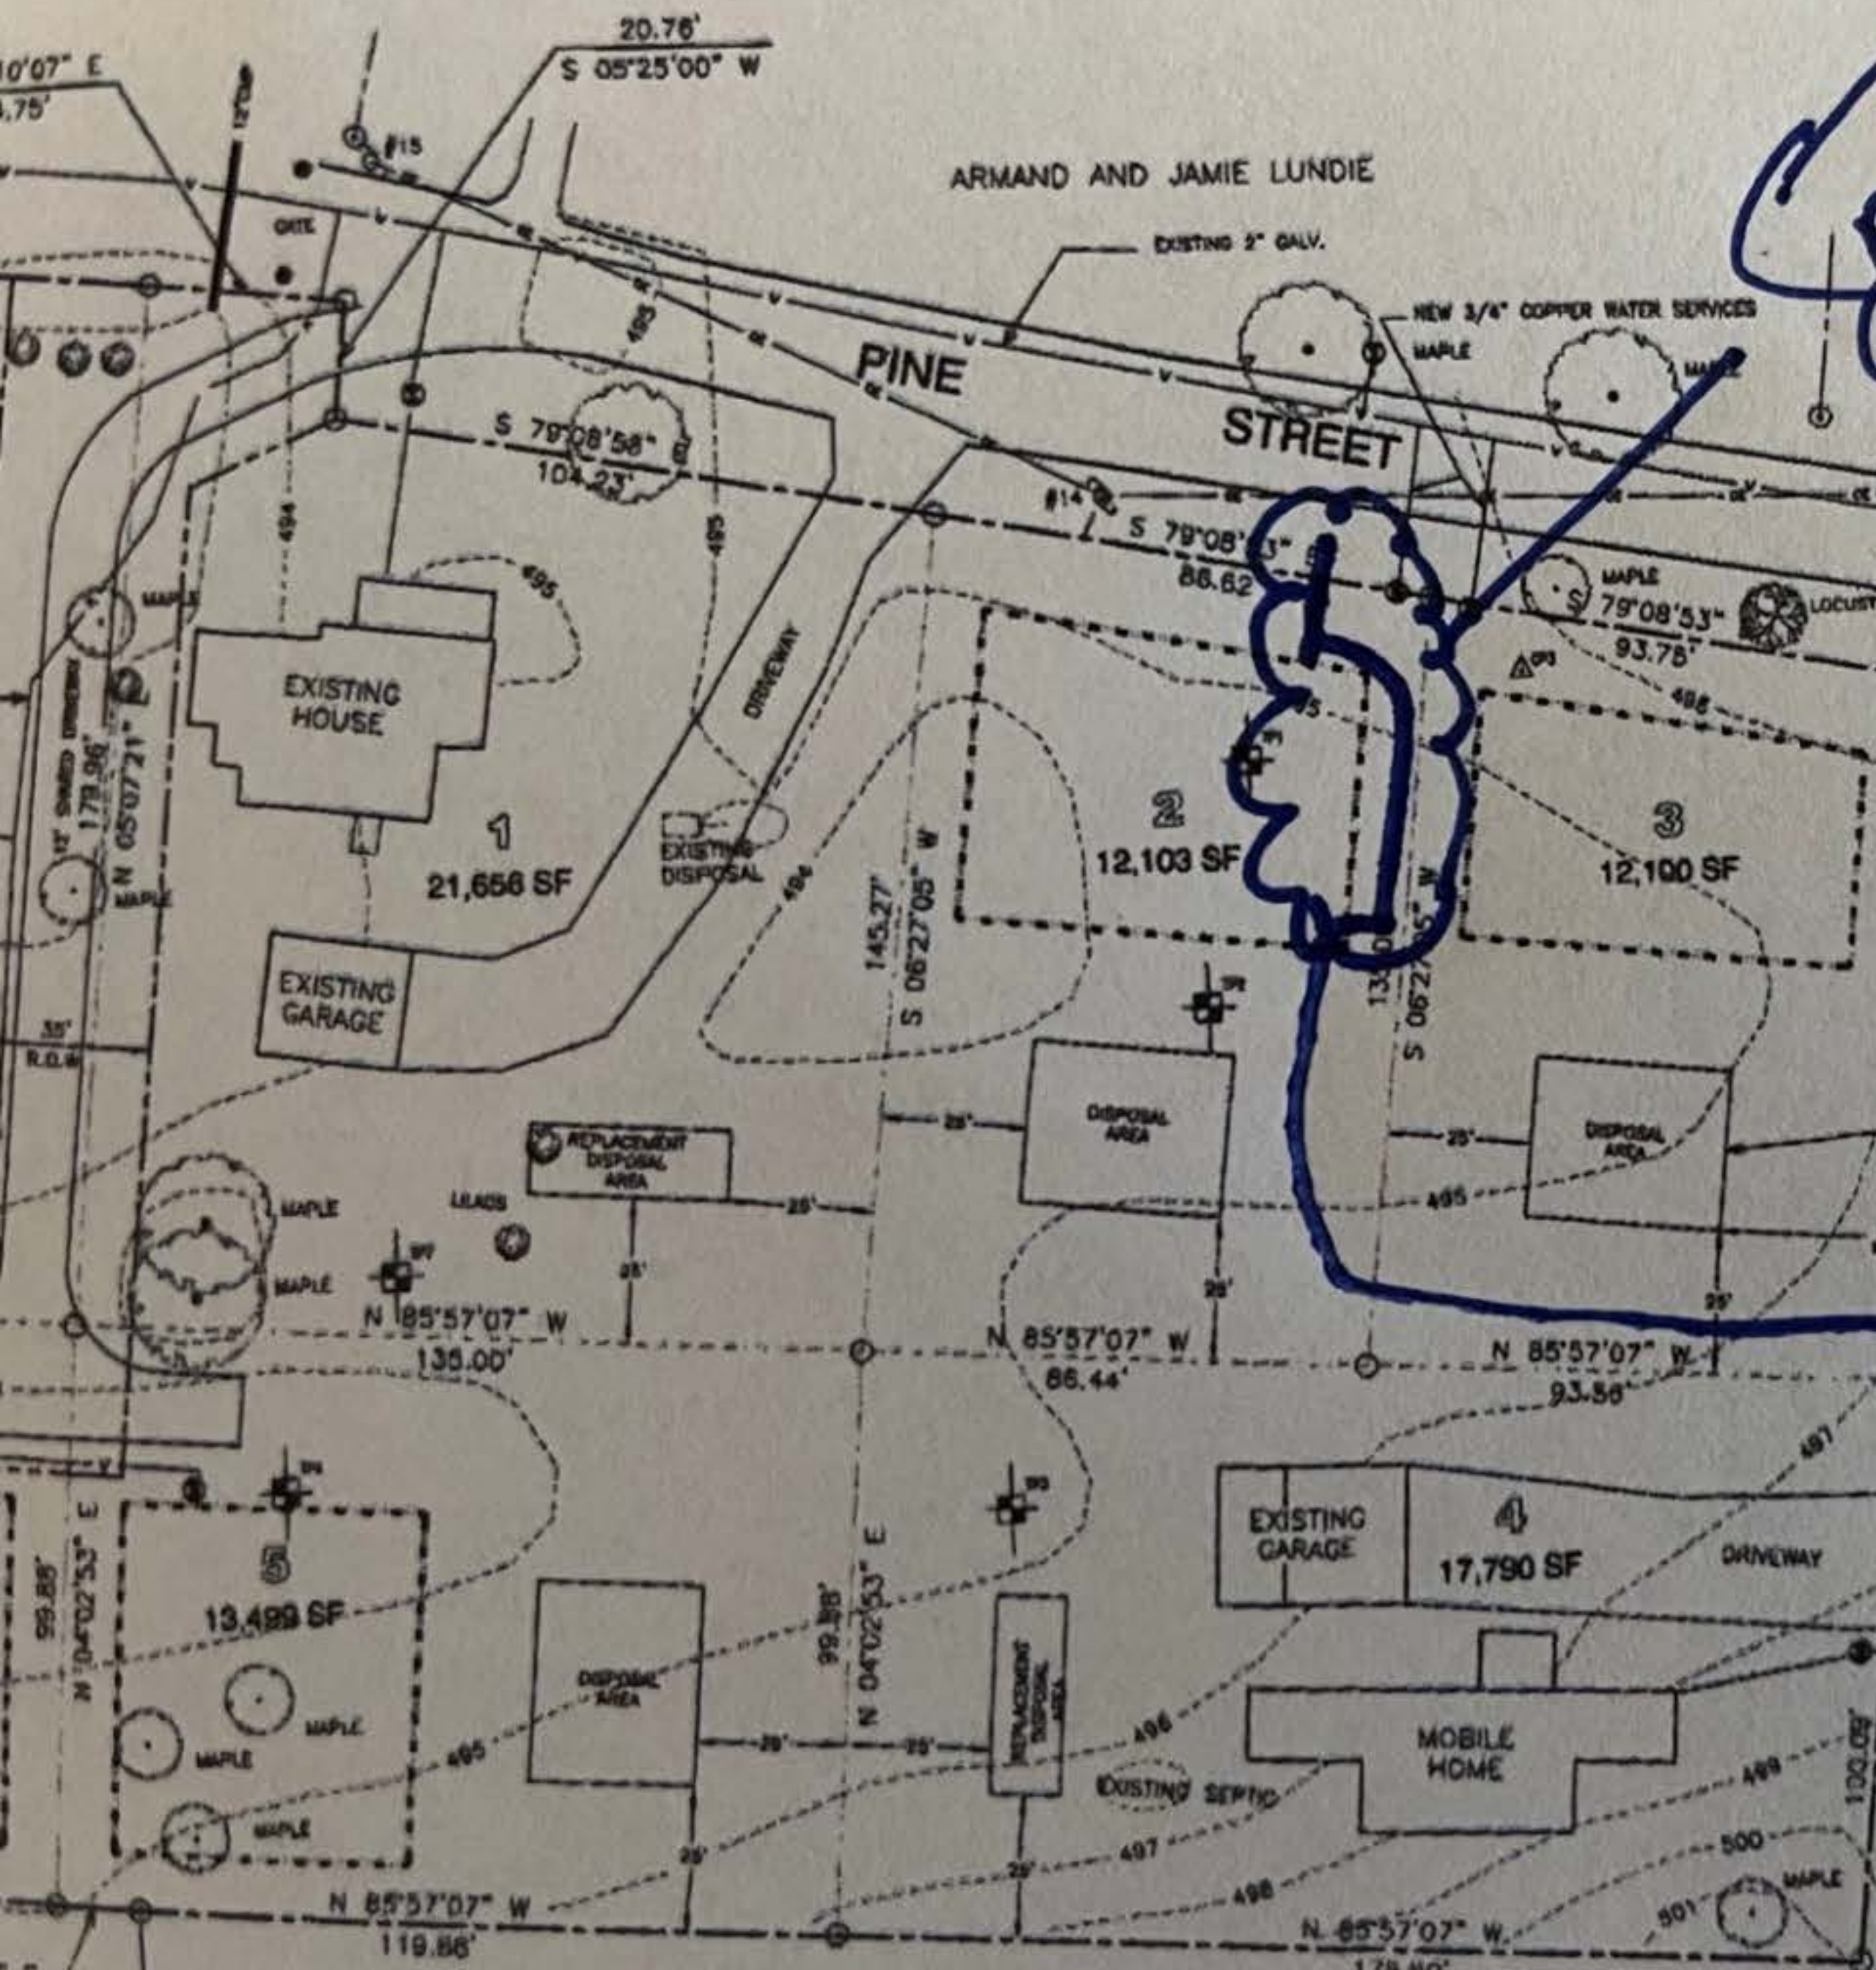

New 3/4" copper service from Pine St.

Existing copper service from Liberty



LEG

	UTILITY LINE
	DISPOSAL AREA
	WATER VALVE
	TREE
	DRIVEWAY
	PROPERTY BOUNDARY
	EASEMENT
	EXISTING STRUCTURE
	PROPOSED STRUCTURE

SITE PLAN

PROJECT BENCHMARK
GROUND AT IRON PIPE
(EL. 500.0)

I HEREBY CERTIFY THAT IN MY JUDGEMENT, THE DESIGN REAPPLICATION IS TRUE, CORRECT AND POTABLE WATER SUPPLY RULES.

[Signature]
MAY TYLER WATT, P. E.