

TOWN OF BRISTOL
Work in Right-of-Way and Access Permit

Office Use Only

Permit #: _____ Parcel #: _____ Town Highway #: _____
Date Received: 10/9/2024 Fee Paid: \$200. - Cash

Check all that apply: Work in Right-of-Way Access Permit (Curb Cut)

A fee of \$100 payable to the Town of Bristol for each application must be submitted.

A permit to work within the Town's right-of-way must be obtained by anyone wishing to use or work within any part of the Town's right-of-way, including but not limited to: curb cut access, water line repair, new water line connection, work on a Class 4 road, and/or projects that affect public sidewalks.

Please provide a sketch on a separate sheet of paper of the parcel and road frontage indicating the location of the proposed project, and other pertinent information, such as: existing accesses, the Town Highway, buildings, drainage ditches, fences, utility poles, and trees or plantings, etc. that may impair visibility; and other information that may be relevant.

Applicant Marthe + Stephen Bryant Phone 240-620-6670

Mailing address 19573 Brassie Place
Montgomery Village, MD 20886

E-mail address _____

Landowner Name Marthe + Stephen Bryant

Property location Next to 139 North Street

Town Road Name: North Street Town Highway #: _____

Company/Individual performing work: _____ Phone: 802-735-5543

Name James Cole - EcoModest Phone: 760-792-1003

Address: 3373 South 116 Rd
Bristol, VT 05443

Work in Right-of-Way

Describe project (including length, width & depth of proposed excavation)
20 ft wide driveway access

Date of start of work Nov 2024 Date of completion _____

The applicant agrees to maintain said access and to adhere to the terms and conditions attached to this permit. In the event all conditions of the access permit are not met within one year the town shall be authorized to affect those conditions at the landowner's expense. Please see attached terms.

TOWN OF BRISTOL
Work in Right-of-Way and Access Permit

Road Frontage of Parcel (number of feet): 150

Proposed Use of Driveway (check all that apply):

- | | | |
|---------------------------------------|--|---|
| <input type="checkbox"/> Agricultural | <input checked="" type="checkbox"/> Single Residence | <input type="checkbox"/> Commercial |
| <input type="checkbox"/> Relocation | <input type="checkbox"/> Change of Use | <input type="checkbox"/> Shared Residential Driveway or Development Road (# Parcels <u> </u>) |
| <input type="checkbox"/> Other | | |

I represent that the information contained in this application is true and that I am authorized to file this application.

[Signature] _____ Date _____
Applicant's signature

Conditions per order of the Public Works Foreman:

Sight distance is good, driveway must be minimum 5' away from catch basin, driveway needs a culvert 15" x 30' gray plastic or discuss other options with foreman, driveway material will be 1/4-1/2 crush gravel 6" deep 30' wide and 17' back from edge of road, driveway must be flat or 2% +/- grade for 17' from edge of road, outlet of culvert not to be below top of catch basin


Ene Cota _____ Date 12-19-24
Public Works Foreman (or designee) signature

All access permit applications require Selectboard approval. Action by Selectboard:

Approved Denied Date: _____

Conditions of approval:

Authorized Signature: _____ Date: _____
Title: _____

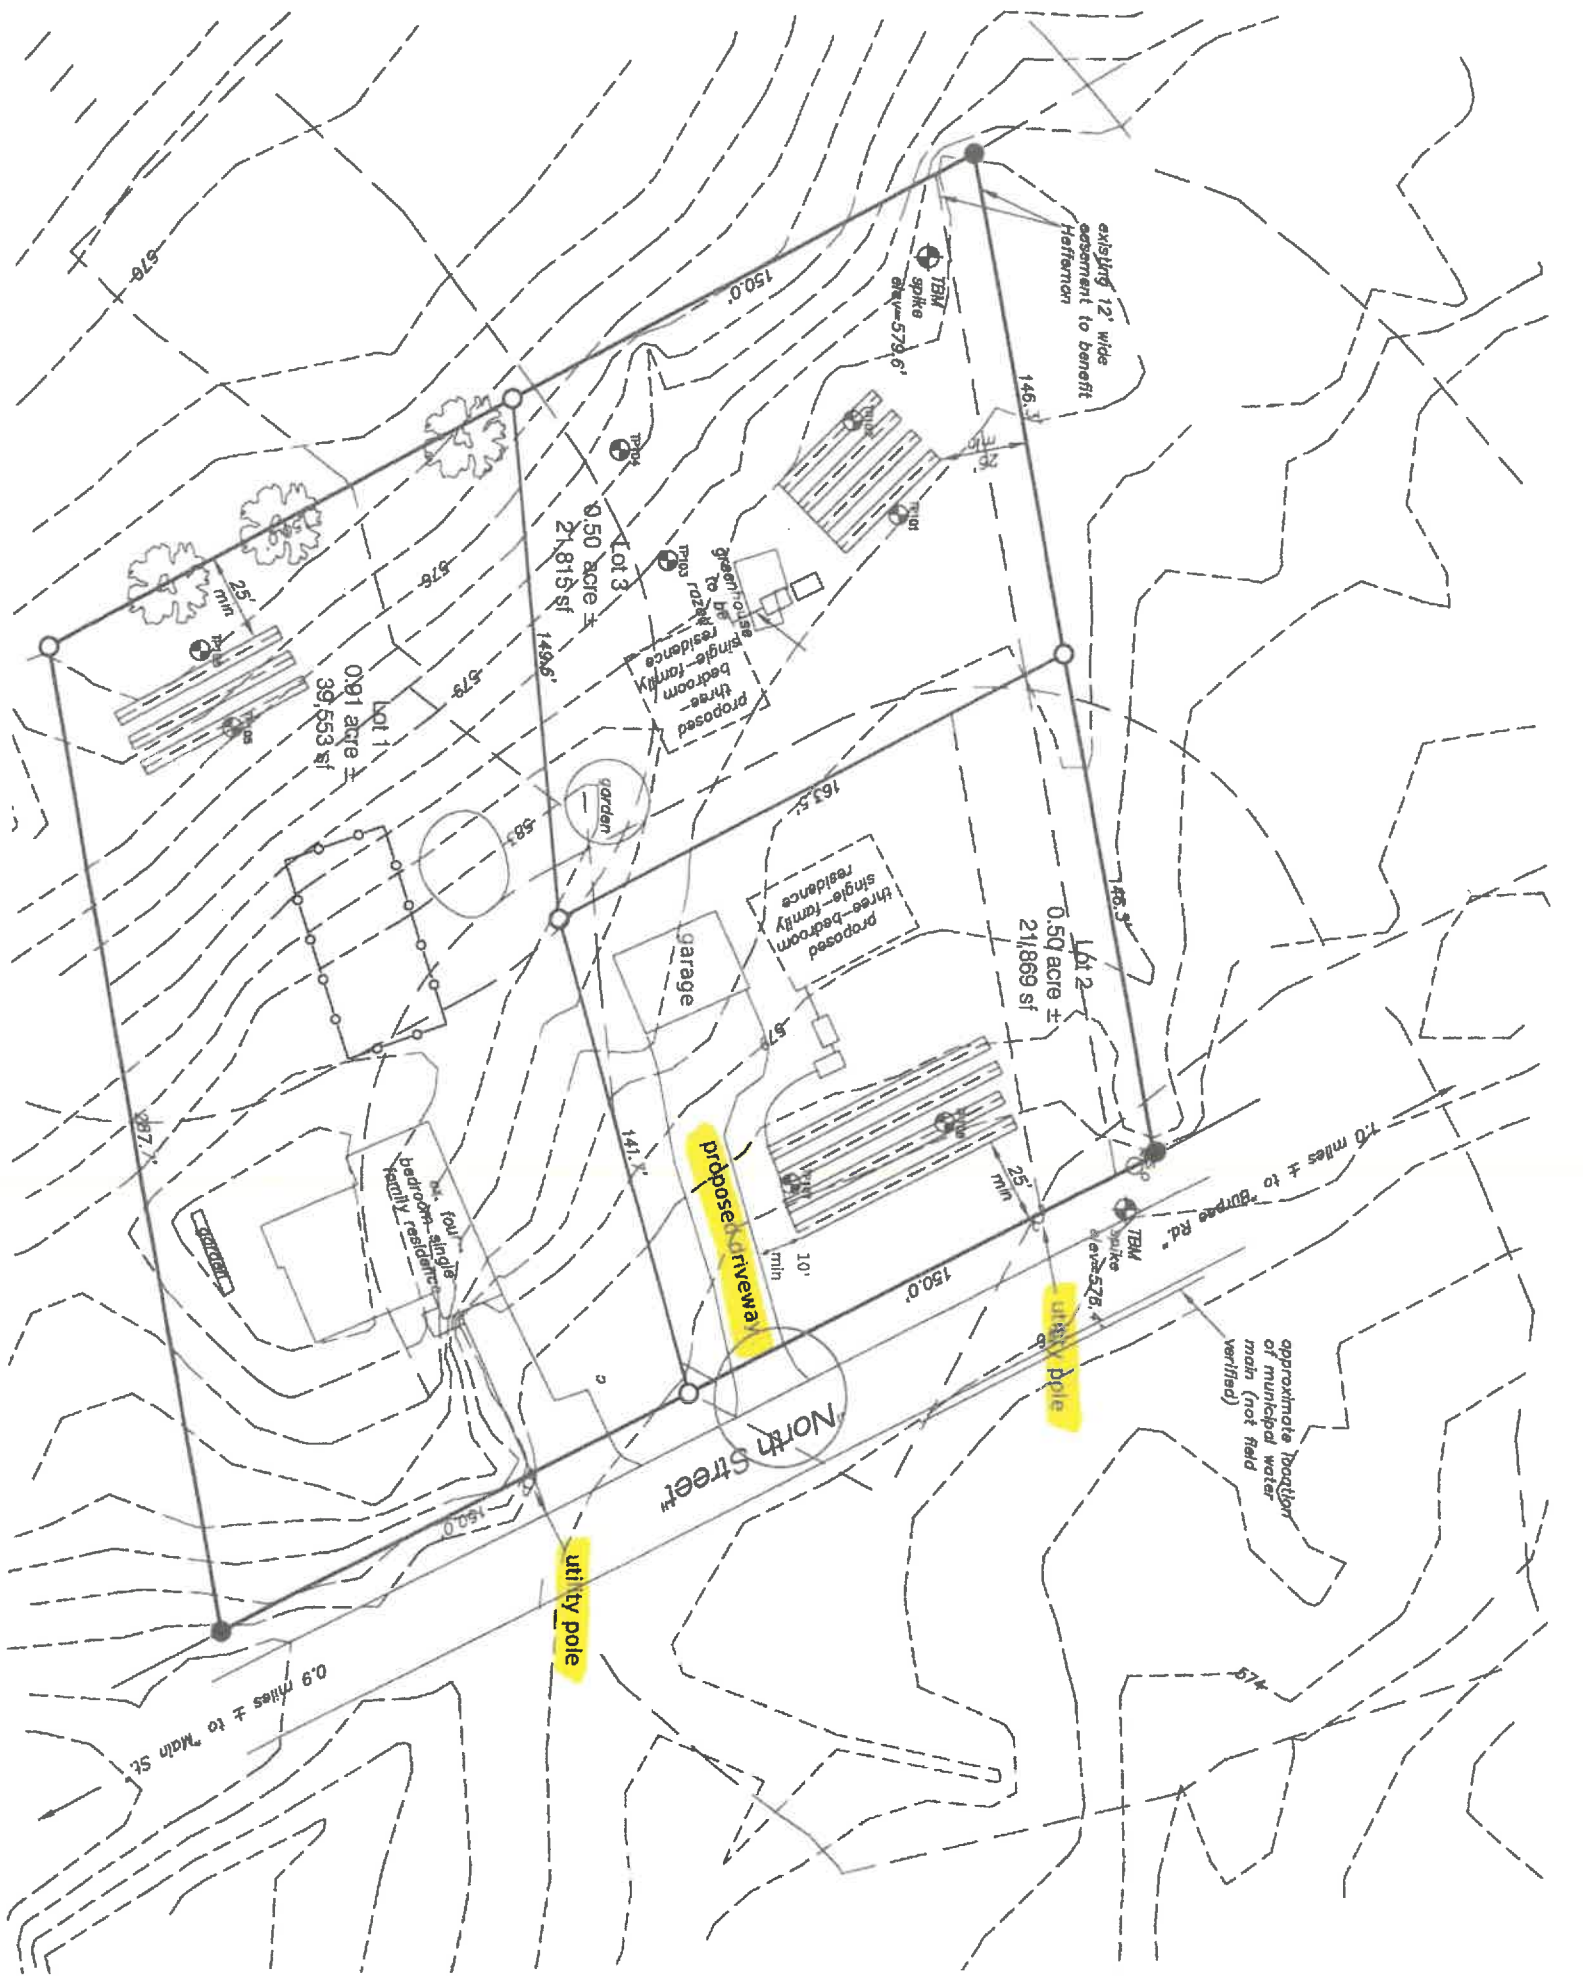

existing 12' wide easement to benefit Heffernan

Lot 3
0.50 acre ±
21,815 sf

Lot 1
0.91 acre ±
39,553 sf

Lot 2
0.50 acre ±
21,869 sf

proposed driveway

utility pole

utility pole

North Street

approximate location of municipal water main (not field verified)

0.9 miles ± to Main St.

1.0 miles ± to Burpee Rd.

578

150.0'

145.3'

576

579

149.6'

581

163.5'

146.3'

587

150.0'

150.0'

479

25' min

25' min

10' min

141.7'

150.0'

25' min

57

150.0'

150.0'

25' min

57

150.0'

150.0'

25' min